
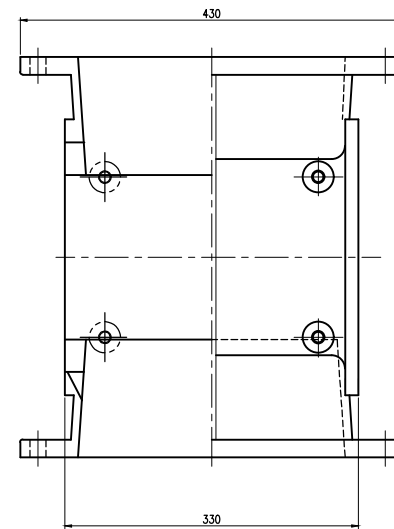
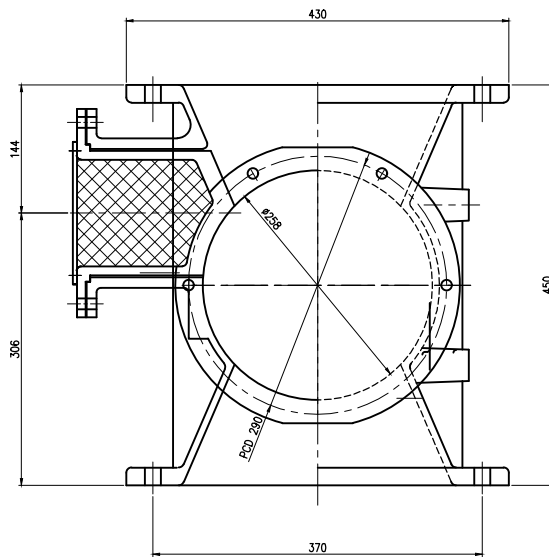
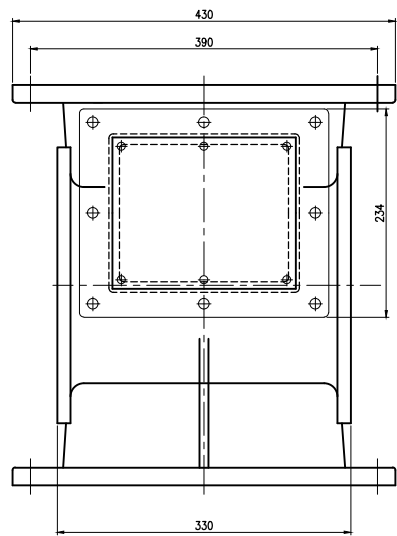


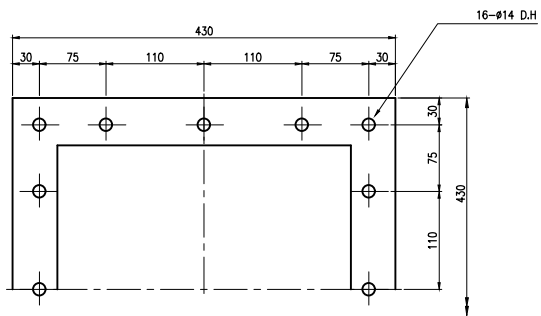

NO.	DESCRIPTION	MAT'(KS)	QUANTITY		WEIGHT(Kg)		REMARK'S
			UNIT	TOTAL	PER UNIT	TOTAL	
1	CASING	SC480	1	144	90	12960	300SQxØ258x450H
2	INSPECTION DOOR	SC480	1	144	5	720	234x280
3	BOLT,NUT,S/W	4T	8	1152	-	-	M10x35L
4	PLATE	SS400	1	144	-	-	160x206x6t
5	BOLT,S/W	4T	6	684	-	-	M10x15L
6	PACKING	SILICON	1	144	-	-	30Wx3t
7	INSULATION	ROCKWOOL	1	144	-	-	
TOTAL					95	13680	

AS BUILT

								CONSORTIUM KOREA COTTINELL CO., LTD. posco eac												SCALE 1/3		PROJECTION 											
												TITLE		GWANG YANG NO.1-NO.4 SINTER PLANT 727 2272								ROTARY VALVE CASING DETAIL		EQUIPMENT		MANUFACTURER NO.		BAG611PGRV0101					
												DRAWN		CHECKED		REVIEWED		APPROVED		[EXPLODED]		DRAWN		CHECKED		REVIEWED		APPROVED					
												J.W. KIM		J.Y. PARK		J.S. YUN						J.W. KIM		J.Y. PARK		J.S. YUN				POSCO PGRV-01			
												DATE		DATE		DATE		DATE				DATE		DATE		DATE		DATE					
												NO.		DATE		REVISIONS & DESCRIPTION		DRAWN		CHECKED		REVIEWED		APPROVED									